

Architect: OpeningDesign
312 W. Lakeside Street | Madison, WI 53715
ryan@openingdesign.com | 773.425.6456

Proposal for Variance on (Sec. 28.151)(f)
335 W. Lakeside St | Madison, WI
06/14/2017 - SITE PLAN - (A100)

3 | | 2 | | 1

RESIDENTIAL (R) TENANT (1)
~(980sf)

RESIDENTIAL (R) TENANT (2)
~(540sf)

BUSINESS (B) TENANT (1)
~(940 sf)


BUSINESS (B) TENANT (2)
~(540 sf)



① DIAGRAM - ELEVATION - EXISTING
1/16" = 1'-0"

BUSINESS (B) TENANT
~(940 sf)

RESIDENTIAL (R) TENANT (1)
~(980sf)

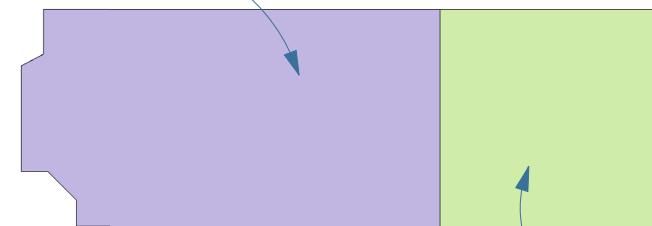

BUSINESS (B) TENANT (2)
~(540 sf)

RESIDENTIAL (R) TENANT (2)
~(540sf)

② AREA DIAGRAM - 1ST FLOOR - EXISTING
1" = 20'-0"


③ AREA DIAGRAM - 2ND FLOOR - EXISTING
1" = 20'-0"




1 | | 2 | | 3



① DIAGRAM - ELEVATION - PROPOSED
1/16" = 1'-0"

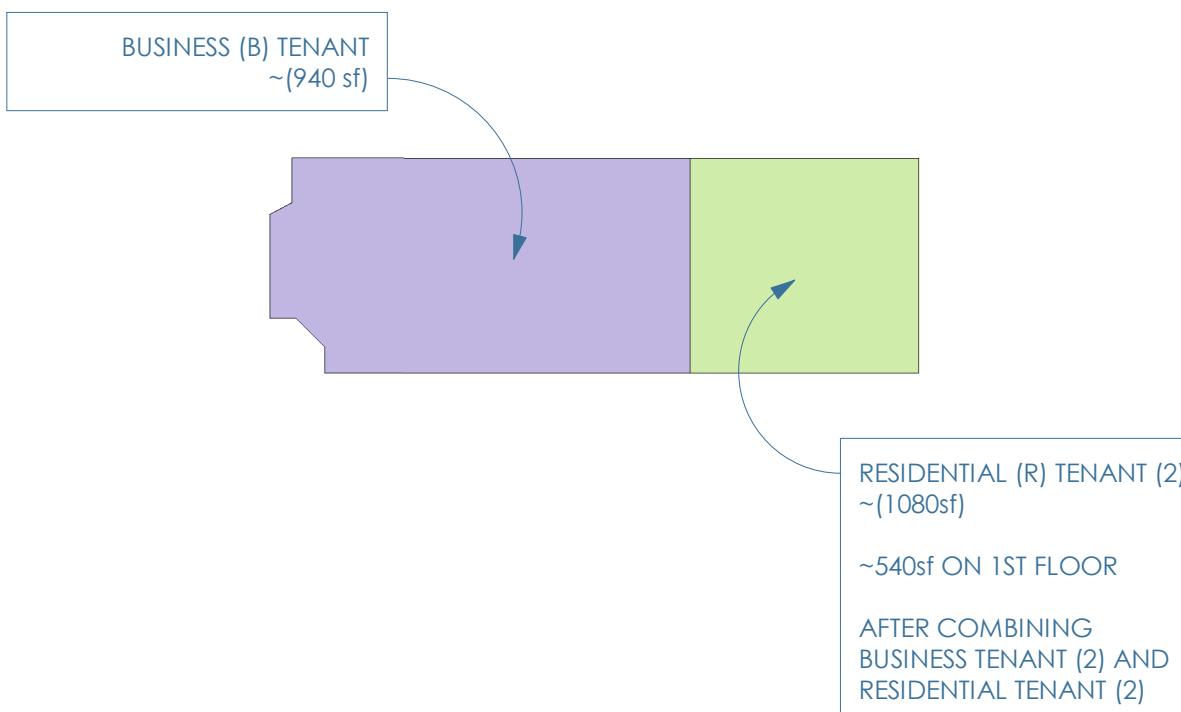

② AREA DIAGRAM - 1ST FLOOR - PROPOSED
1" = 20'-0"

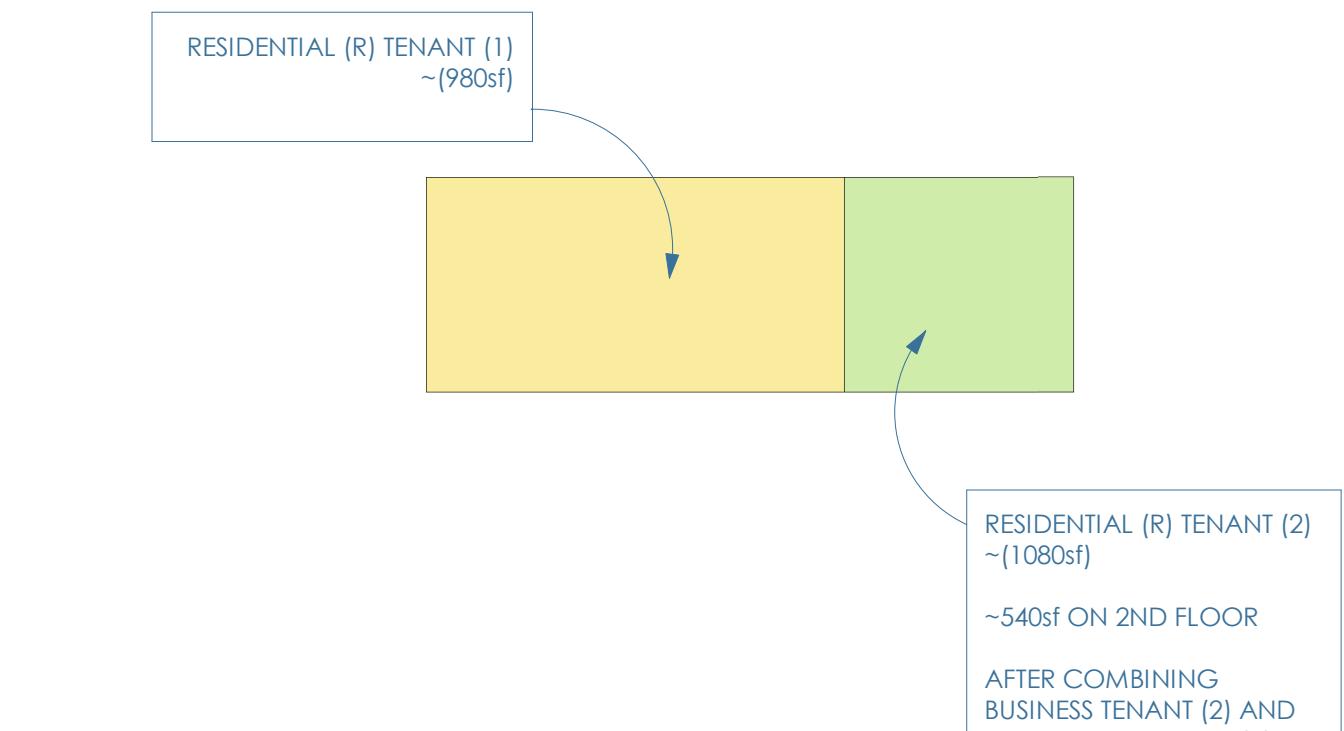

③ AREA DIAGRAM - 2ND FLOOR - PROPOSED
1" = 20'-0"