


1 Existing Tenant Floor Plan
1/4" = 1'-0"

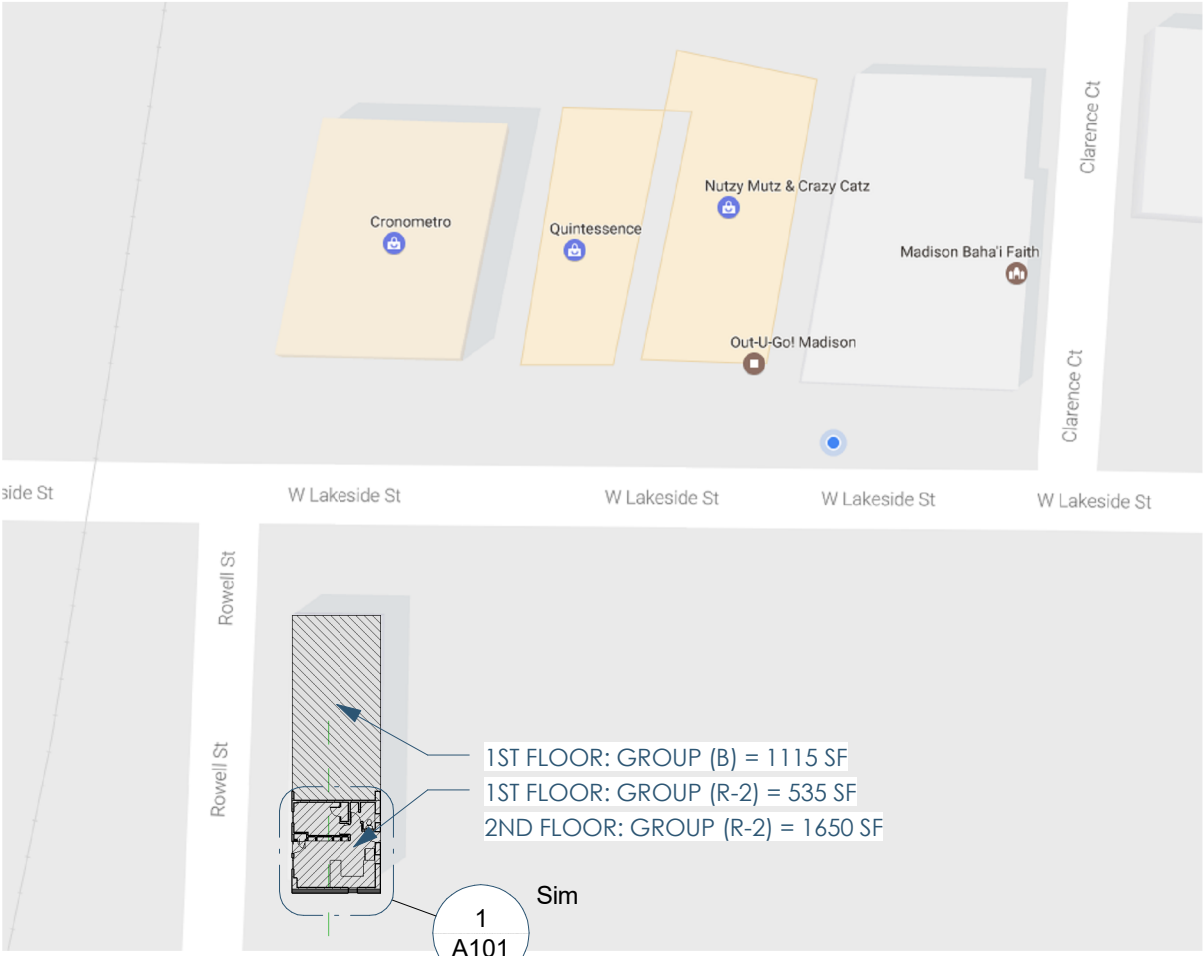

2 Site Plan
1" = 50'-0"

TABLE 503				
ALLOWABLE BUILDING HEIGHTS AND AREASa				
USE CLASSIFICATION		TYPE OF CONSTRUCTION	Actual number of stories, building height above grade plane, and building area per story.	
		TYPE V		
		B		
	HEIGHT (feet)	40	≥	30
B	S	2		
	A	9000		
R-2	S	2	≥	2
	A	7000	≥	1650
(shaded)	= Most Restrictive Occupancy Class. Used toward non-separated (508.3) occupancies			



Architect: OpeningDesign

312 W. Lakeside Street | Madison, WI 53715
ryan@openingdesign.com | 773.425.6456

Existing Residential Apartment
335 W. Lakeside St. | Madison, WI
04/04/2017 - Existing Floor & Site Plan - (A101)